


NEW CONDOMINIUM SUMMARY		
UNIT NO.	TYPE	SIZE
101	2 BR / 1 BA	690 S.F.
102	2 BR / 1 BA	683 S.F.
103	3 BR / 1.5 BA	1170 S.F.
104	2 BR / 1 BA	1119 S.F.
201	2 BR / 1 BA	900 S.F.
202	2 BR / 1 BA	758 S.F.
203	2 BR / 1 BA	792 S.F.
204	2 BR / 1 BA	708 S.F.
301	2 BR / 1 BA	1053 S.F.
302	2 BR / 1 BA	776 S.F.
303	2 BR / 1 BA	767 S.F.


**LEGEND**

- ▲ MAIN ENTRY
- △ SECONDARY ENTRY
- ▨ COMMON AREA
- ▩ EXCLUSIVE USE AREAS (PER UNIT)

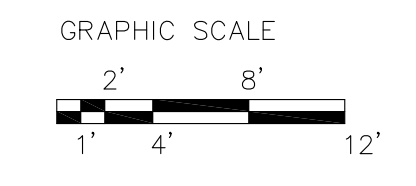


**NOTES**

UNLESS NOTED OTHERWISE ALL DIMENSIONS SHOWN ARE TAKEN FROM THE INSIDE FACE OF STUD

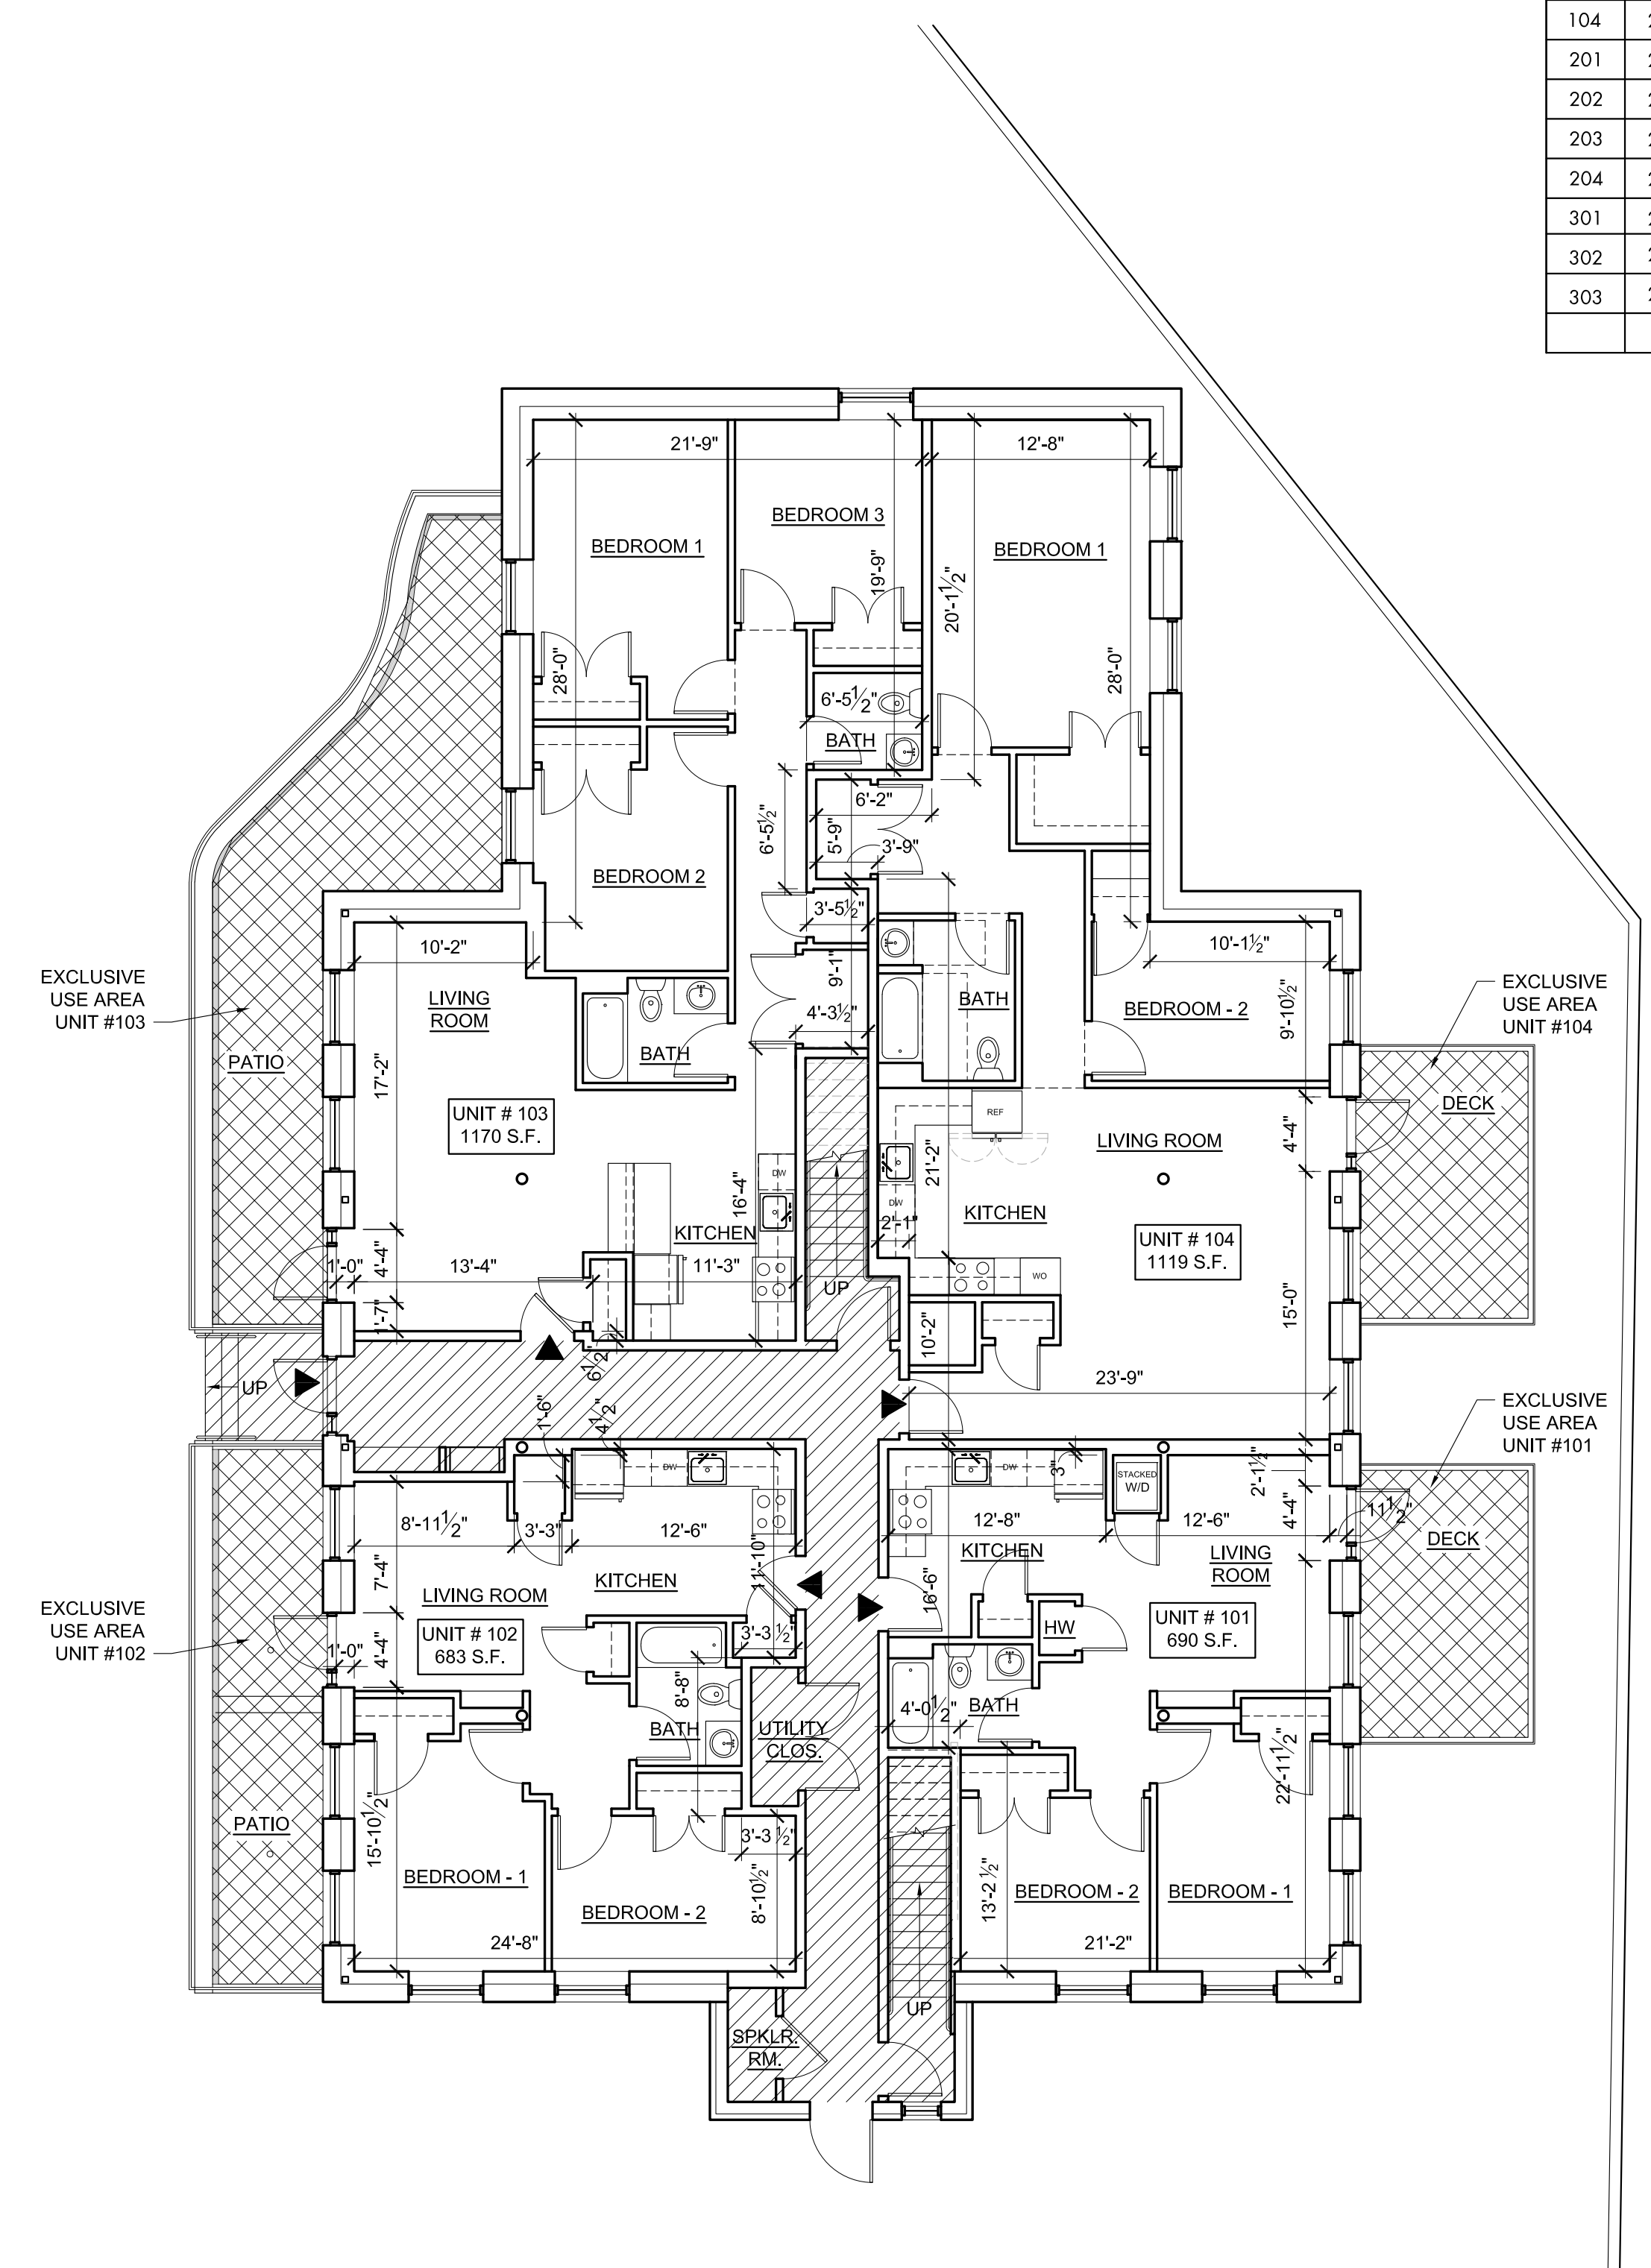

FIRST FLOOR PLAN - UNIT #'s 101, 102, 103, 104  
1/8"=1'-0"

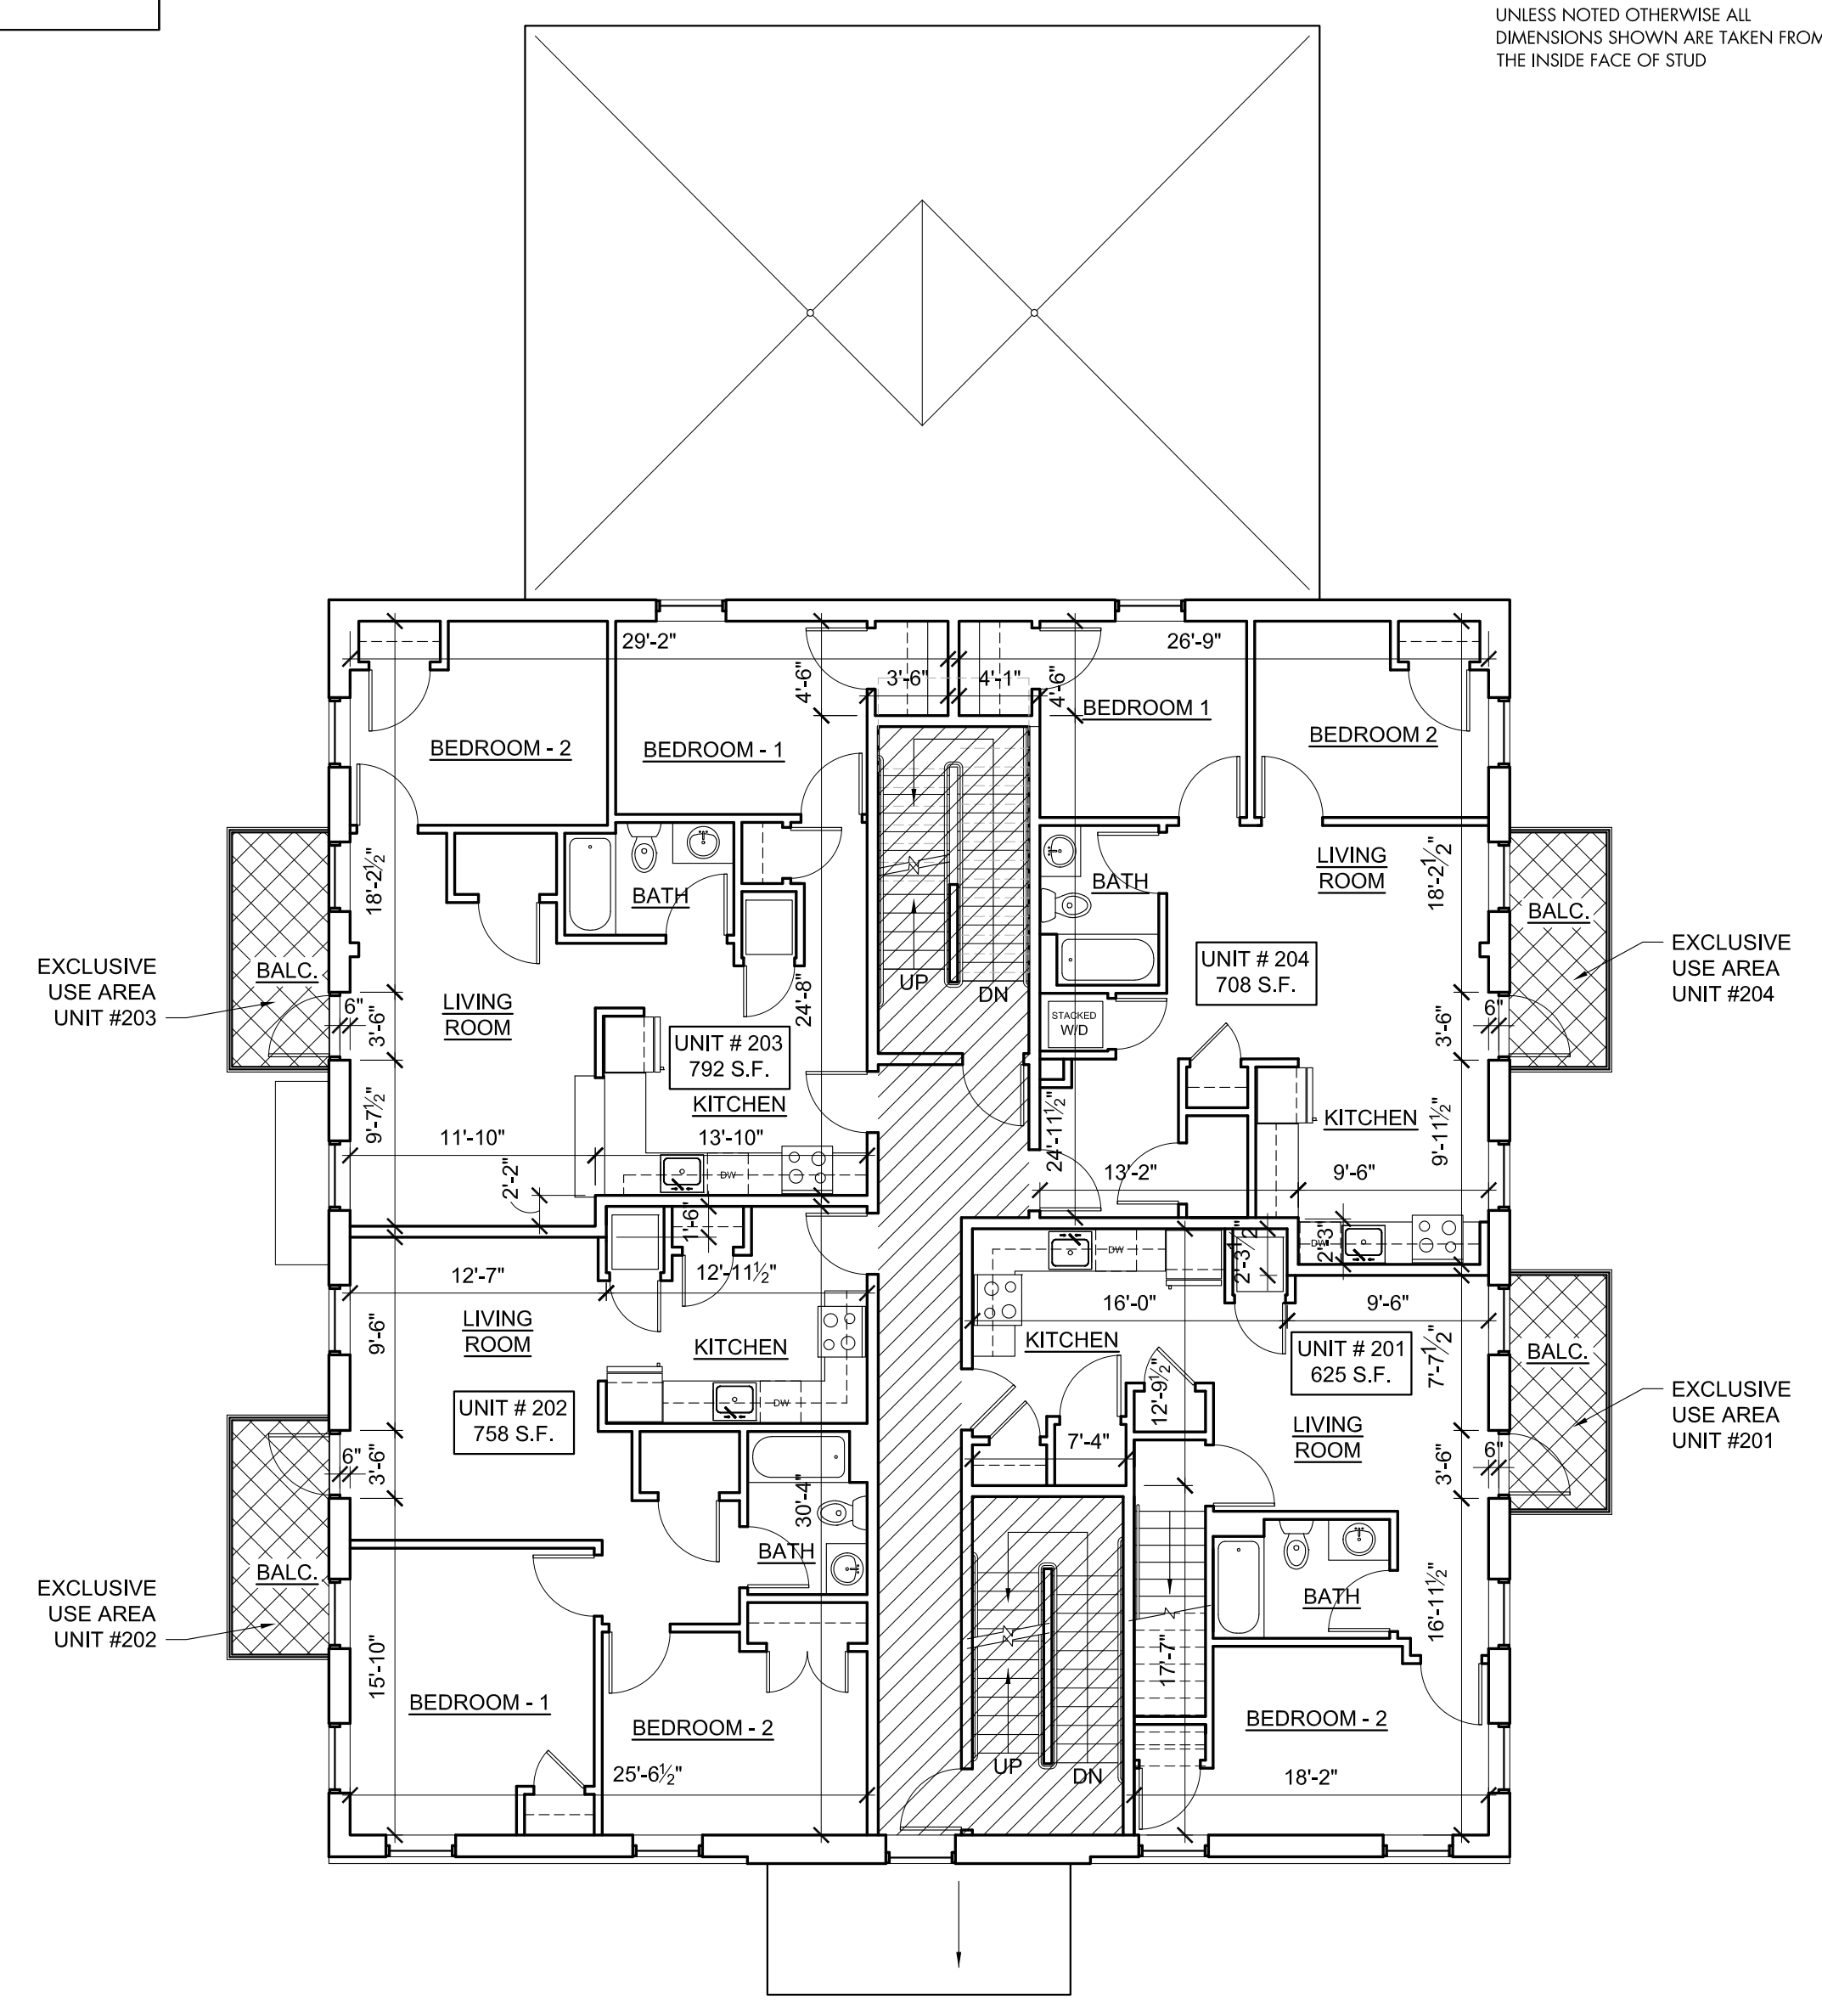


SECOND FLOOR PLAN - UNIT #'s 201, 202, 203, 204  
1/8"=1'-0"

**CERTIFICATION FOR CONDOMINIUM PLANS OF MASTER DEED**

I hereby certify that this plan fully and accurately depicts the layout, location, unit numbers, dimensions, approximate area, main entrance and immediate common areas to which the units have access, as built, of Units #101-#104, #201-#204 and #301-304 in the GLEN STREET CONDOMINIUM as built.


I certify that this plan was prepared in conformity with the rules and regulations of the Registers of Deed of the Commonwealth of Massachusetts as amended January 1, 1976.

Tric Rex  
MA. REG. # \_\_\_\_\_ Date \_\_\_\_\_

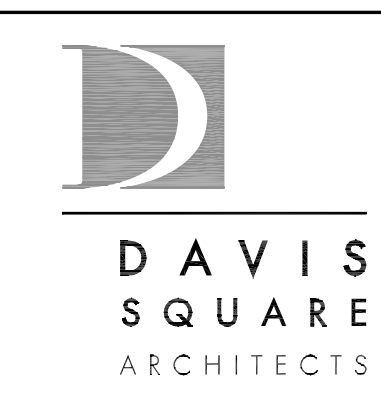





240A Elm St.  
Somerville, MA 02144  
617 628 5700  
www.davissquarearchitects.com

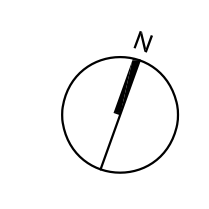
Consultant		
Project GLEN STREET CONDOMINIUM 163 GLEN STREET SOMERVILLE, MA		
Drawing Title MASTER DEED (FLOOR PLANS)		
Designer JA	Project No. 14020	DWG File Name SCC-MD_163
Checked JA	Scale 1/8"=1'-0"	
Reviewed IR	Drawing No. <b>MD1</b>	
Date 9-24-2019		



NEW CONDOMINIUM SUMMARY		
UNIT NO.	TYPE	SIZE
101	2 BR / 1 BA	690 S.F.
102	2 BR / 1 BA	683 S.F.
103	3 BR / 1.5 BA	1170 S.F.
104	2 BR / 1 BA	1119 S.F.
201	2 BR / 1 BA	900 S.F.
202	2 BR / 1 BA	758 S.F.
203	2 BR / 1 BA	792 S.F.
204	2 BR / 1 BA	708 S.F.
301	2 BR / 1 BA	1053 S.F.
302	2 BR / 1 BA	776 S.F.
303	2 BR / 1 BA	767 S.F.


LEGEND

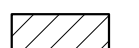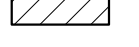-  MAIN ENTRY
-  SECONDARY ENTRY
-  COMMON AREA
-  EXCLUSIVE USE AREAS (PER UNIT)

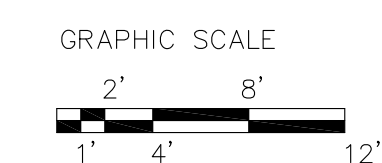

NOTES

UNLESS NOTED OTHERWISE ALL DIMENSIONS SHOWN ARE TAKEN FROM THE INSIDE FACE OF STUD

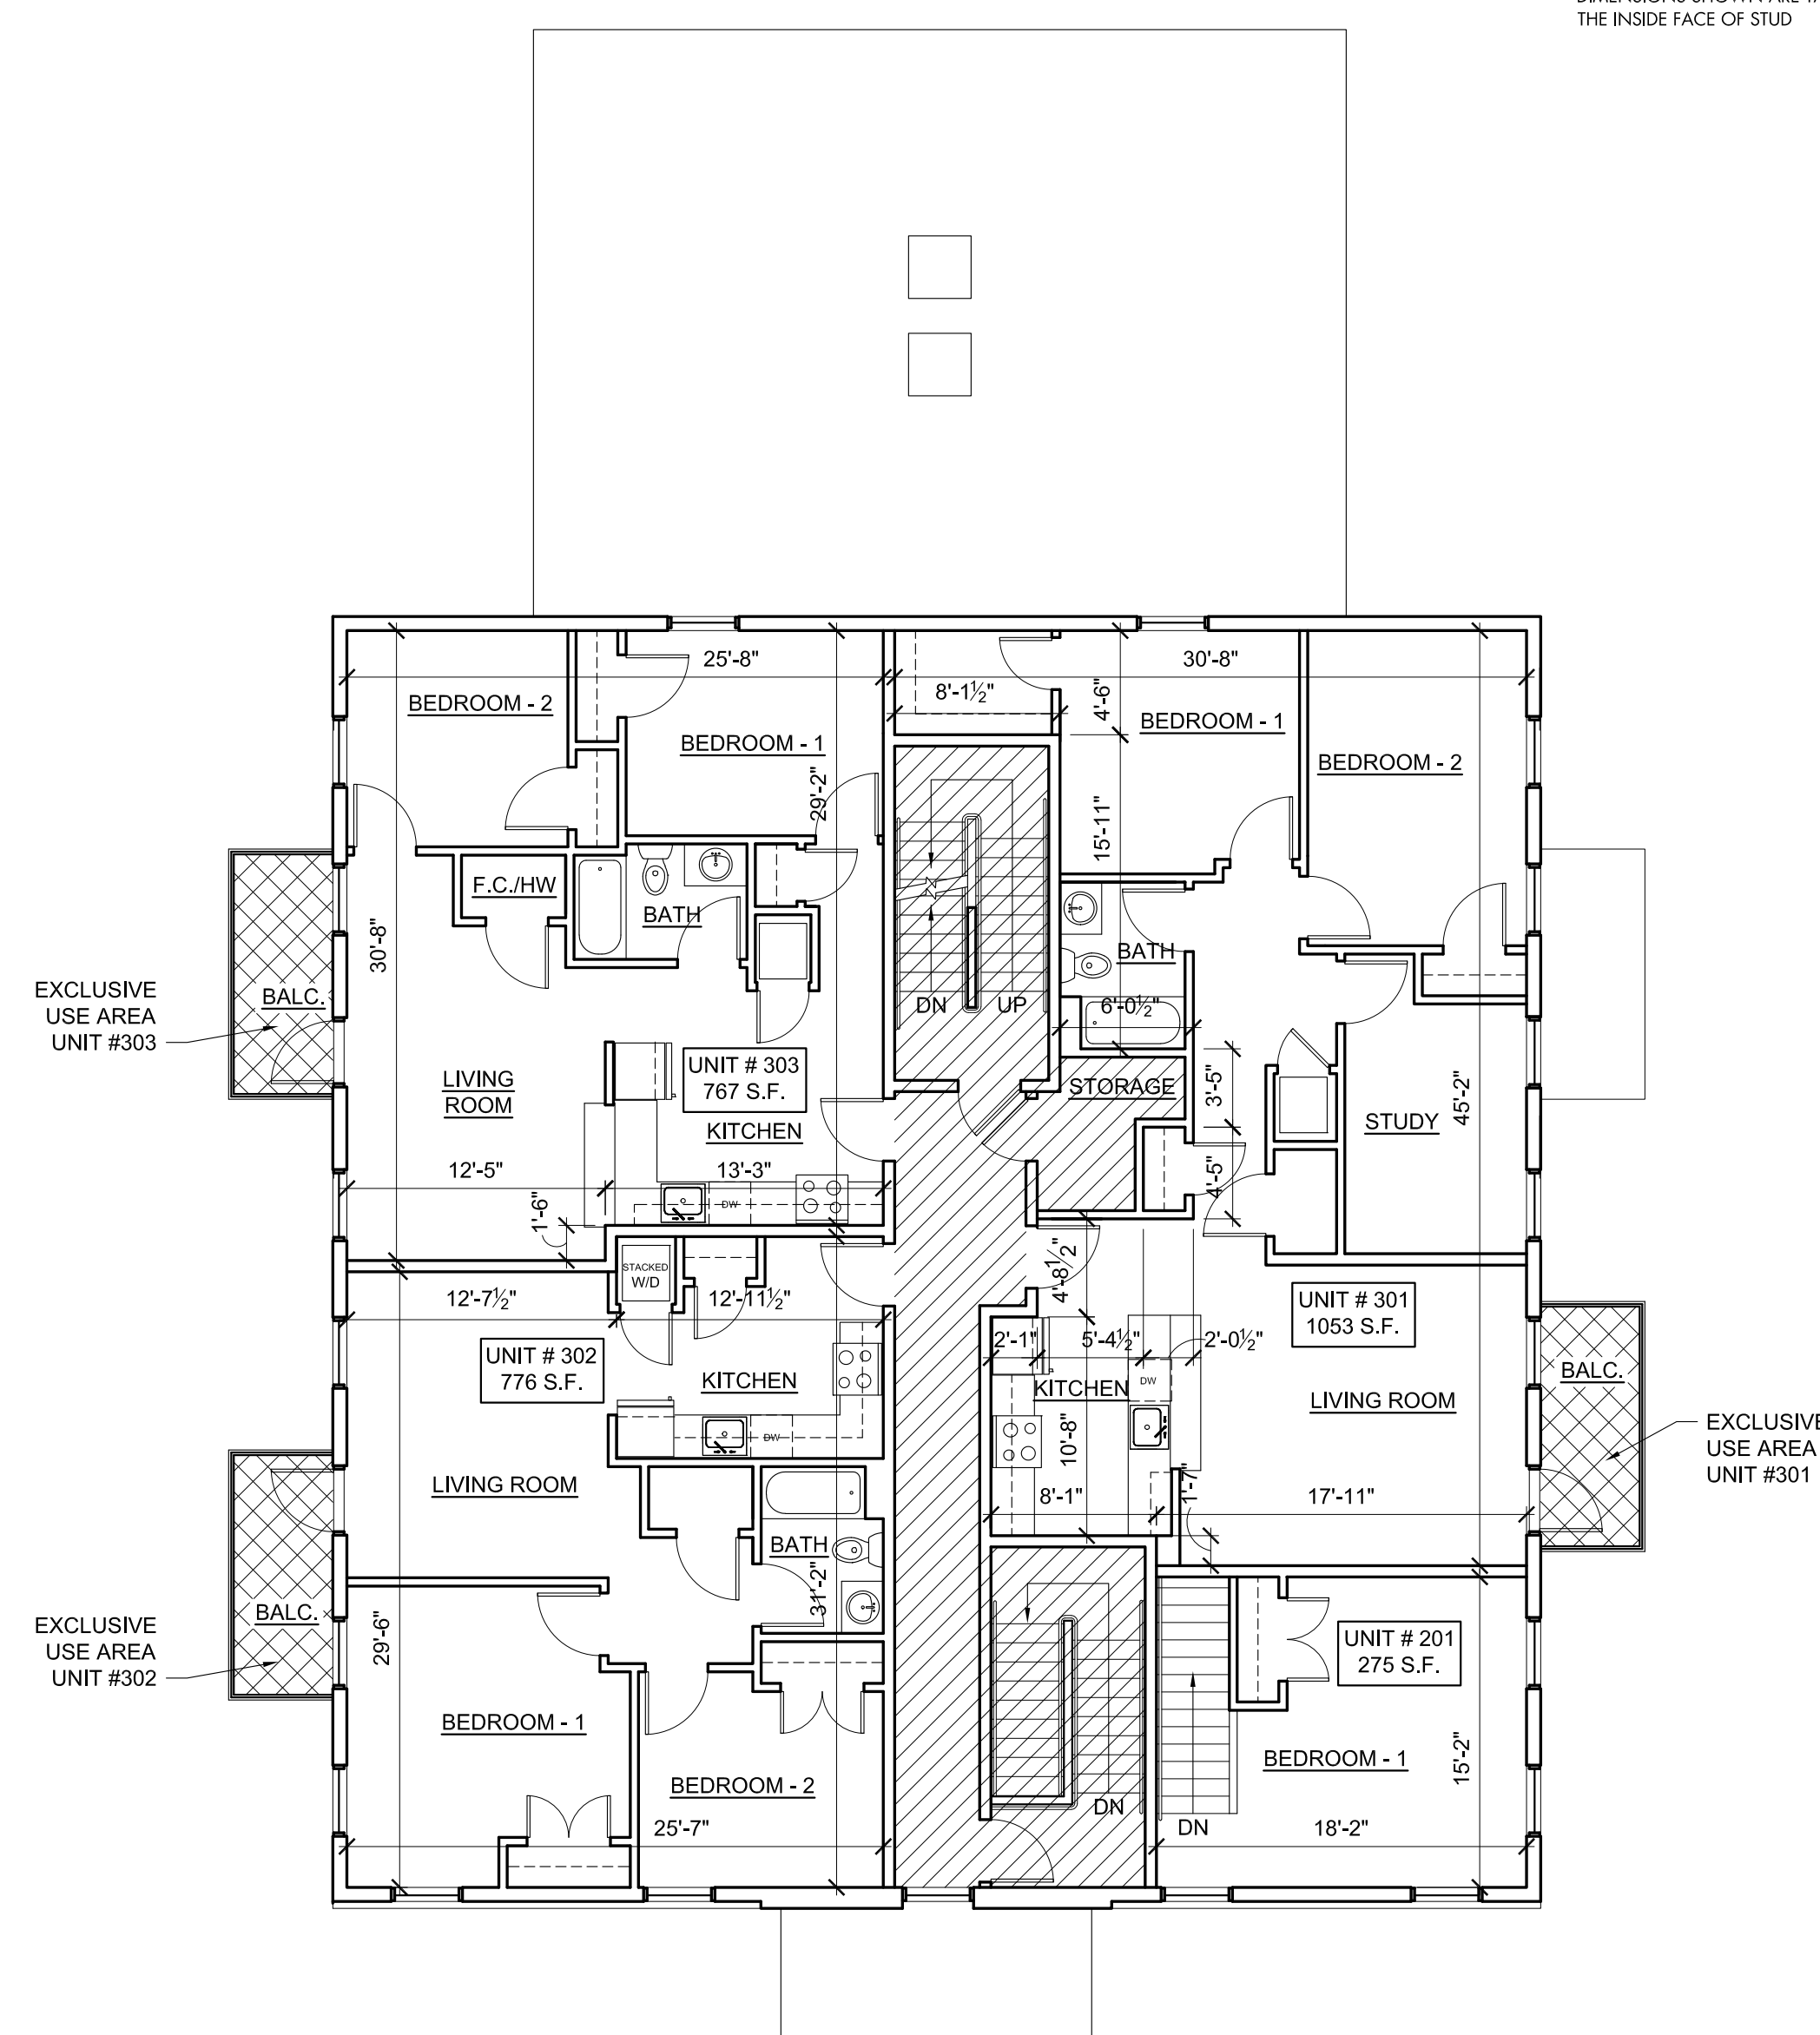

THIRD FLOOR PLAN - UNIT #'s 201, 301, 302, 303  
1/8"=1'-0"

CERTIFICATION FOR CONDOMINIUM PLANS OF MASTER DEED

I hereby certify that this plan fully and accurately depicts the layout, location, unit numbers and dimensions of Units #119 Jericho Road, #121 Jericho Road, #123 Jericho Road, and #125 Jericho Road in the STONEGATE AT WESTON CONDOMINIUM as built.

I certify that this plan was prepared in conformity with the rules and regulations of the Registers of Deed of the Commonwealth of Massachusetts as amended January 1, 1976.

Eric Rex  
MA. REG. # \_\_\_\_\_ Date \_\_\_\_\_



240A Elm St.  
Somerville, MA 02144  
617 628 5700  
www.davissquarearchitects.com

Consultant		
Project GLEN STREET CONDOMINIUMS 163 GLEN STREET SOMERVILLE, MA		
Drawing Title MASTER DEED (FLOOR PLANS)		
Designer JA	Project No. 14020	DWG File Name SCC-MD_163
Checked JA	Scale 1/8"=1'-0"	
Reviewed IR	Drawing No. <b>MD2</b>	
Date 9-24-2019		

